


Basement Floor As-Built Plan

Second Floor As-Built Plan

NO.	DATE	REVISIONS

PREPARED BY
DIGITAL ARCHITECTURE
 digitalarchitecture.com
 TEL (805) 494-0163
 FAX (805) 494-3670

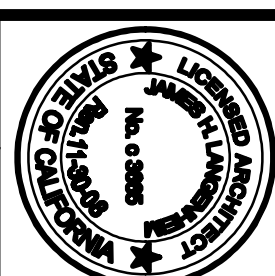

PROJECT
5023 N. Calabasas Parkway
 SHEET TITLE
Second & Basement Floor As-Built Plan

ADDRESS
5023 N. Parkway Calabasas
5023 N. Parkway Calabasas
Calabasas, California 91302-1421

Date: 09-05-08
 Scale: 1/8"=1'-0"
 Drawn:
 Job:
 Sheet:
2nd
 1 of Sheets